



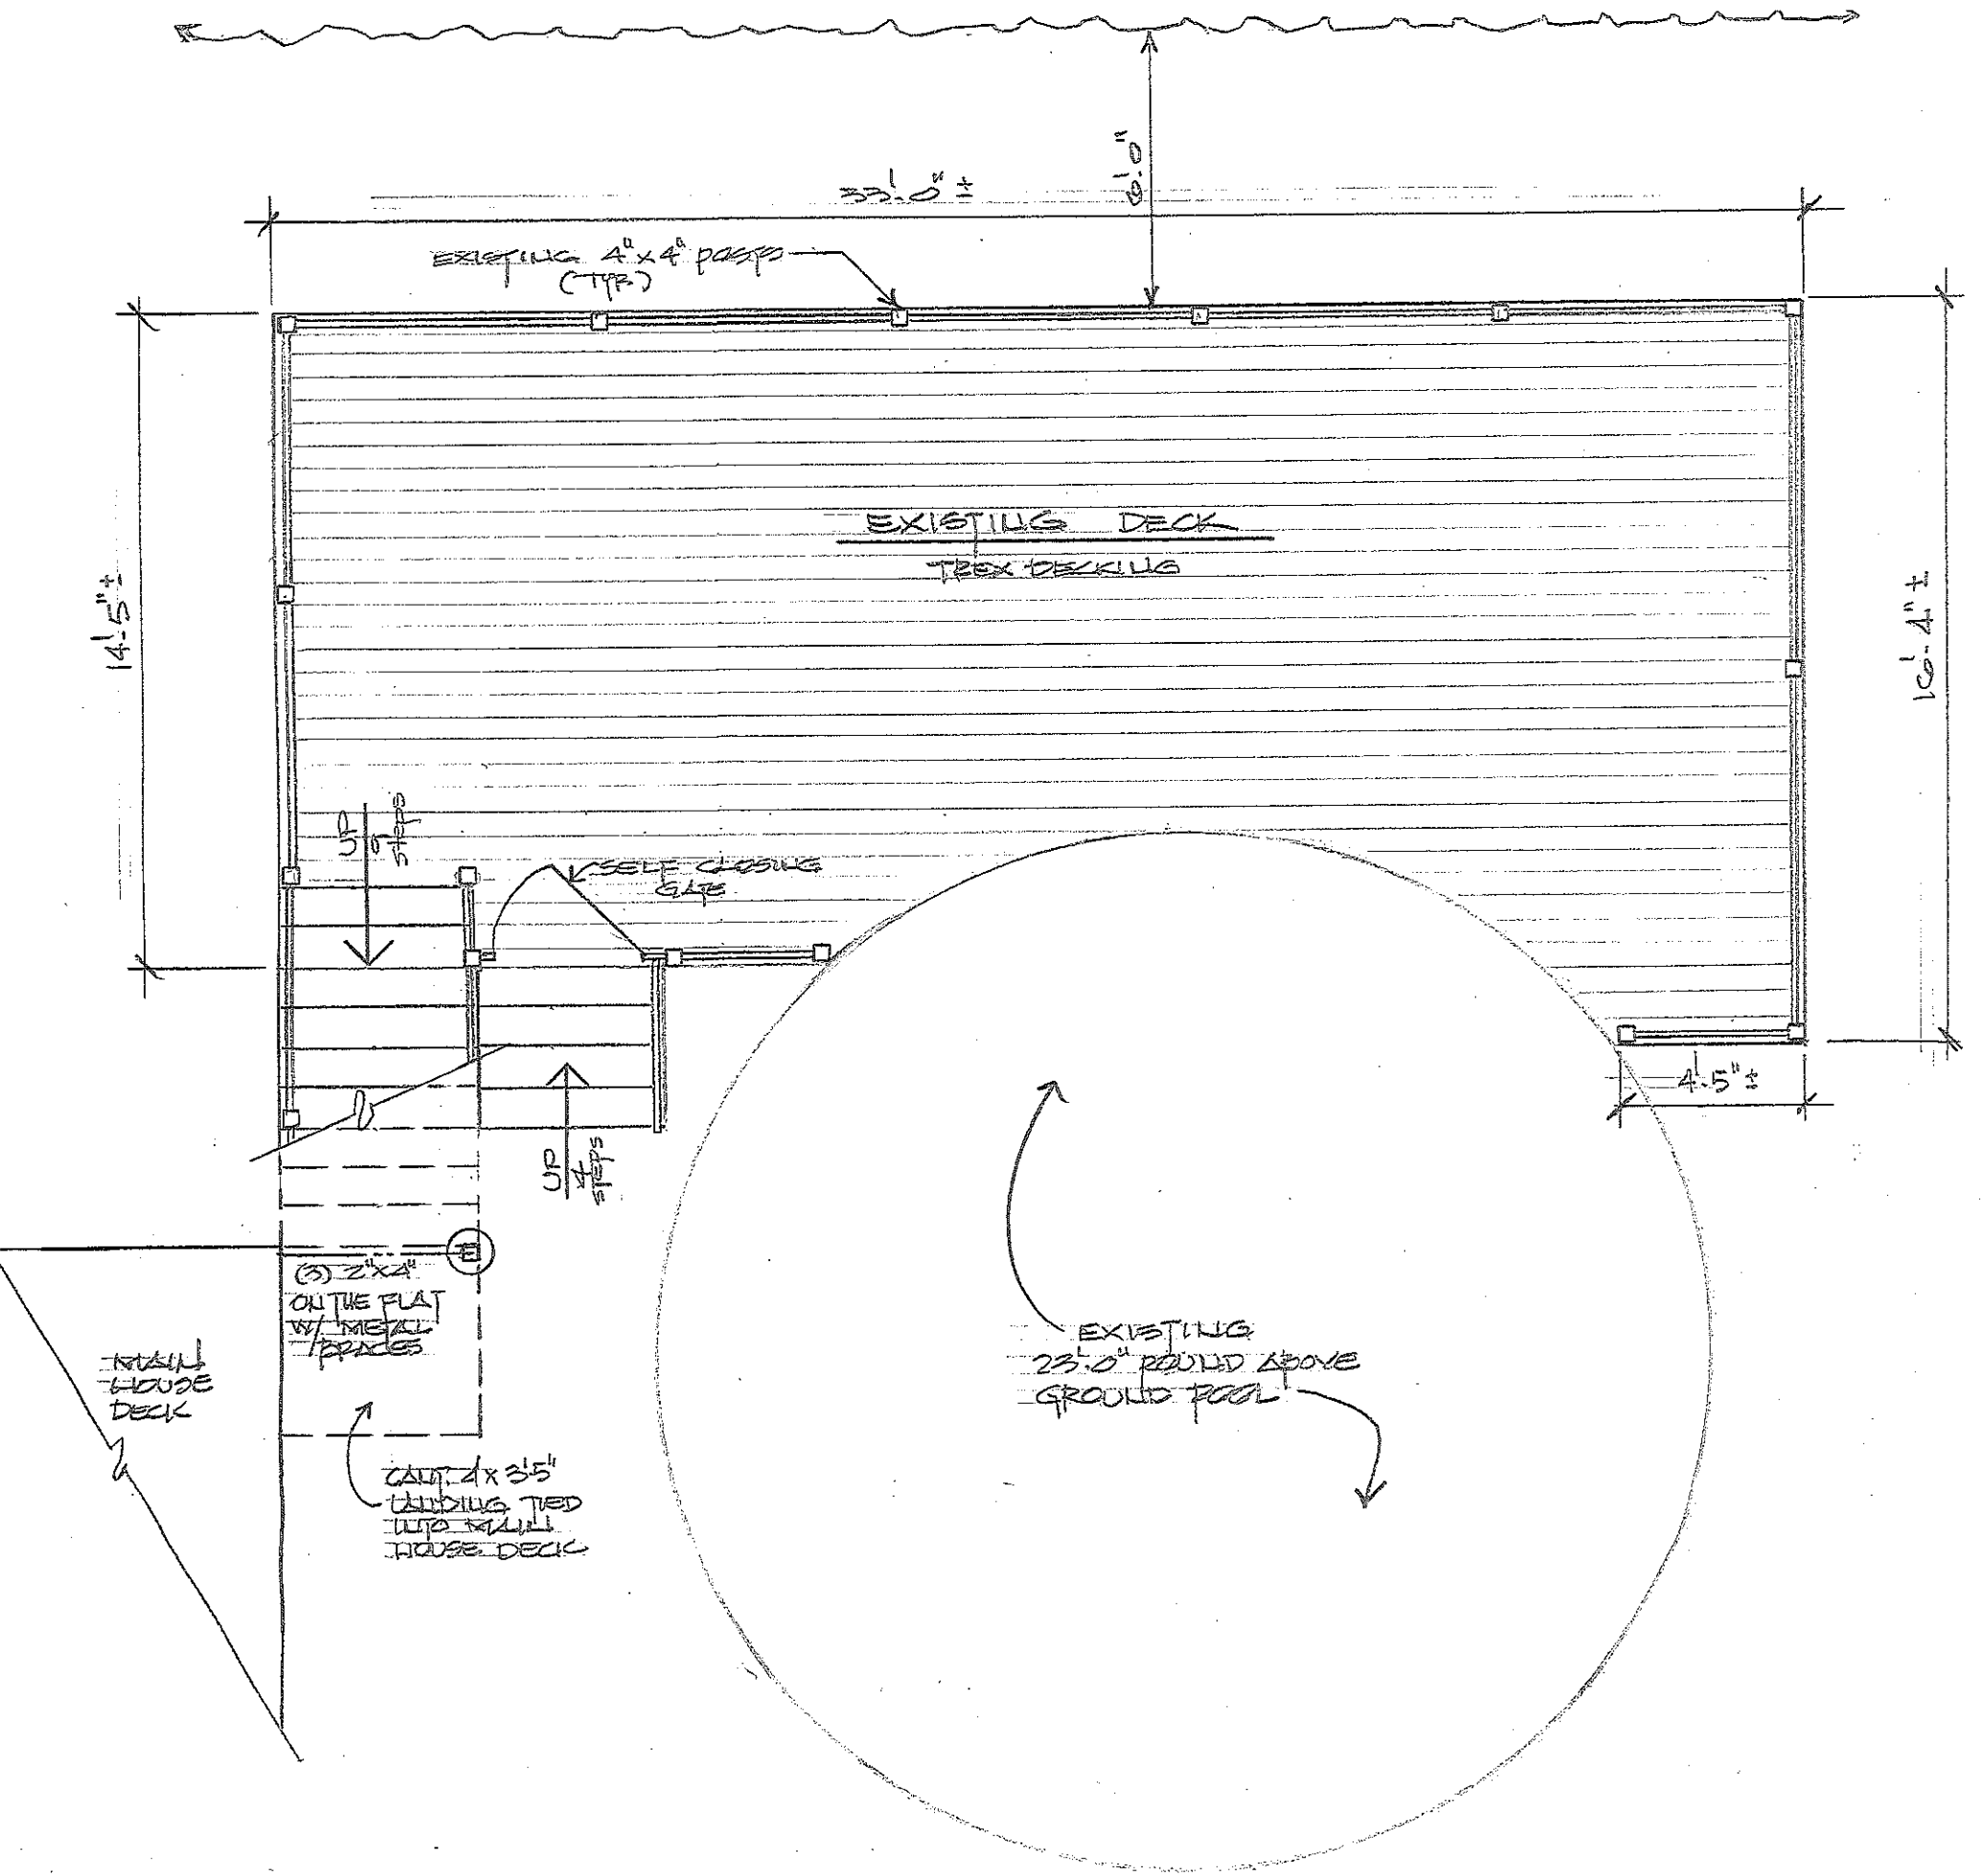

EXISTING POOL & DECK PLAN


1/4" = 1'-0"

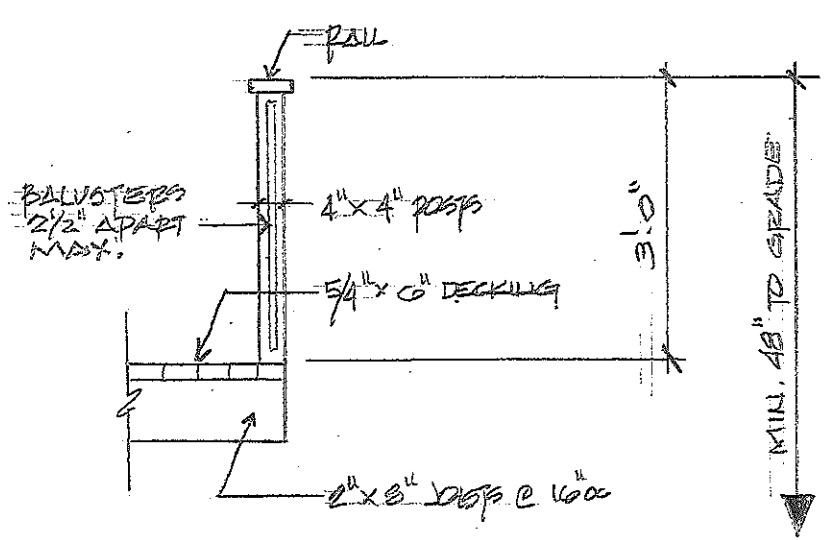

RAILING DETAIL

1/4" = 1'-0"

"AS-BUILT"

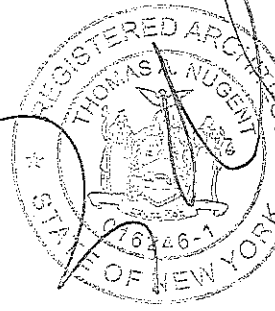

RE TO
SAFETY
24
1.5
1.5
TOP
SIDE

Stairs shall have
R311.7.8 with closed
runner so that a 4"
gs shall be 36" high
ive nosings. Railings
so as to not allow a 6"
astium and breads

INSTALLATIONS
BY ELECTRICIAN
WESTCHESTER CO.
OSSING PERMIT.

EXISTING POOL & DECK, DETAIL, NOTES	
"AS-BUILT" DRAWINGS FOR:	DT: S
PAUL QUADRAS	DN: I
6 GUALTIERE LAKE	REL: S
OSSING, NY 10502	
LRL DESIGNS	1
188 OLD WEST POINT ROAD E.	
GARRISON, NY 10524 914-474-2687	